FORM R.L.-7 REV. 2-40

SHEET 1 OF 3

PREPARED BY
HIGHWAY PLANNING SURVEY
IN COOPERATION WITH
U. S. PUBLIC ROADS ADMINISTRATION

STATE OF MINNESOTA
DEPARTMENT OF HIGHWAYS
ROAD LIFE STUDIES
CONSTRUCTION PROJECT LOG RECORD

CONTROL SECTION 3413
TRUNK HIGHWAY 23
COUNTY Kandiyohi
DISTRICT 8A

LIMITS: N. Jct. T.H. 71 - Jct T.H. 9

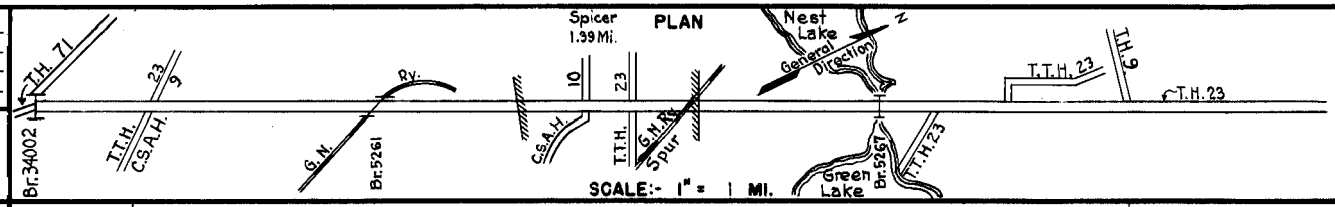

YEAR BUILT	PROJECT Nº	DESCRIPTION: TYPE	WIDTH	THICKNESS	REMARKS	CODE Nº
		Gravel	22'	2"	No Record of Constr.	
1932	71=4-44-2	Grading	40'			
1932	(1) 71=4-44-2	Oil Tr. Gravel	24'	1½"	Maint. Dept.	
1933	71=4-44-1	Grading Gravel Br. 5261 & 5267	40' 30' 27'	5"	3000 C.Y./Mile. 143' B.S.-O.H. & 99' B.S.	
1934	(1) 71=4-44-1	$CaCl_2$ Stab. Gravel	30'	2½"	With Binder Soil. Method No. 1. Maint. Dept.	
1935	(1) 71=4-44-1	Oil Tr. Gravel	24'	1½"	Maint. Dept.	
M 1941	A.F.E. 55	Frost Boils			Maint. Dept.	
M 1941	A.F.E. 37	Spot Treat. Bit. Surf. Repair			Rd. Oil, 1314 Gal./Mi. Grav. 414 C.Y./Mi. Maint. Dept.	
M 1943	A.F.E. 4	Bit. Surf. Repair			Oil, 2223 Gal./Mi. Grav. 71 C.Y./Mi. Maint. Dept.	
M 1947	A.F.E. 4 A.F.E. 5	Spot Treat. Bit. Surf. Repair & Bit. Seal Coat	24'		SC3 & RC3, 42158 Gal. Agg. 1511 C.Y.	
M 1948	A.F.E. 4	Spot Treat. Bit. Surf. Repair	30'		MC-3, 4220 Gal. Agg. 236 C.Y.	
M 1949	A.F.E. 4	Bit. Surf. Repair	26'		SC-3, 70204 Gal. Agg. 5796 Tons	
M 1950	A.F.E. 4	Bit. Fog Seal	24'		RC-1, 12574 Gal. Agg. 310 C.Y.	
C 1950	3412-08	Concrete	22'	9-7-9		

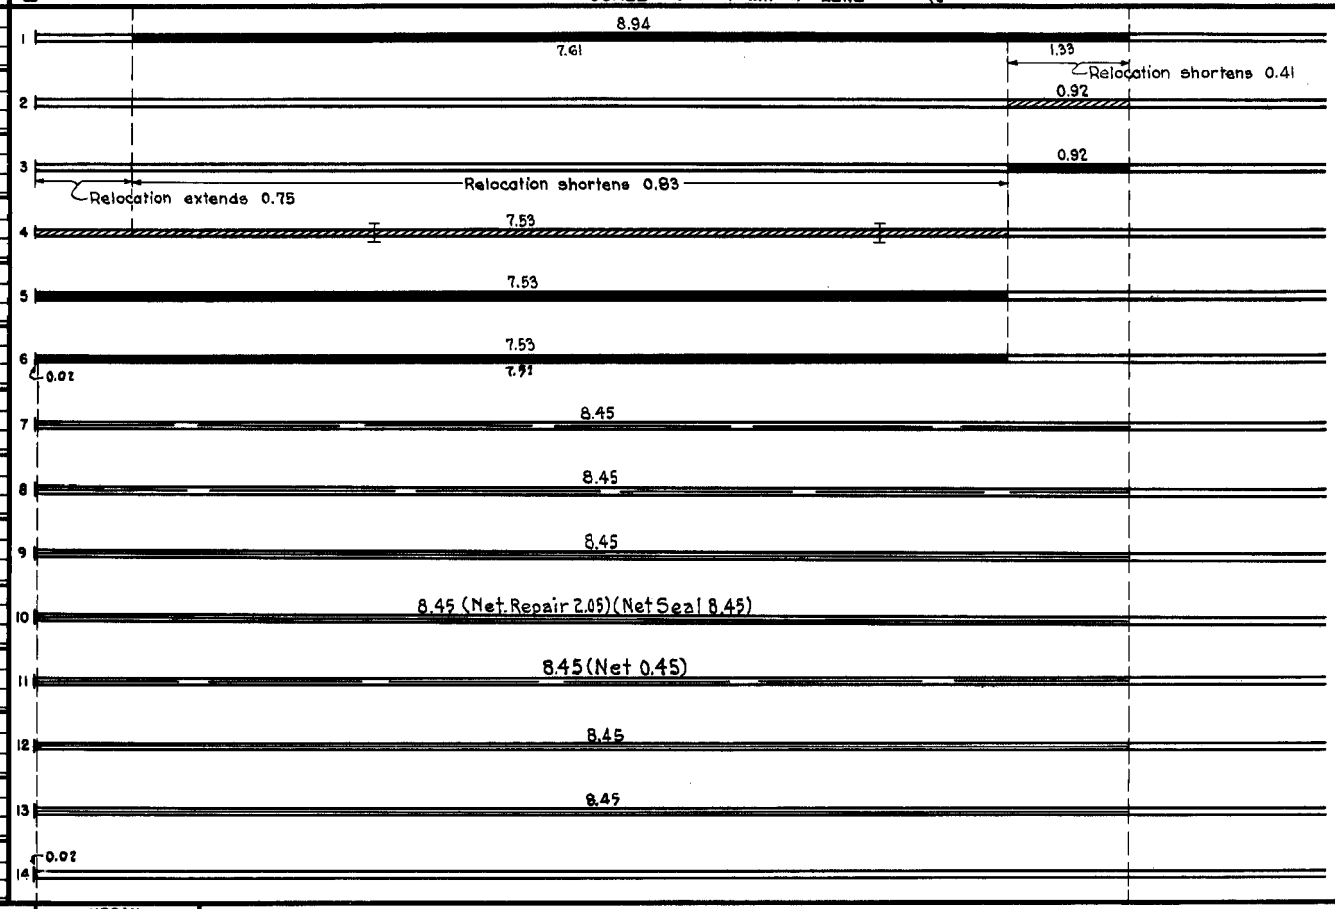

YEARS FROM	YEARS TO	TOTAL MILES	UNINCORPORATED RDWY. MI.	UNINCORPORATED BR. MI.	INCORPORATED RDWY. MI.	INCORPORATED BR. MI.	RURAL RDWY. MI.	RURAL BR. MI.	URBAN RDWY. MI.	URBAN BR. MI.
1921	1931	8.94	7.53	0.00	1.41	0.00	8.94	0.00	0.00	0.00
1932	1932	8.53	7.12	0.00	1.41	0.00	8.53	0.00	0.00	0.00
1933	1962	8.45	7.01	0.05	1.39	0.00	8.40	0.05	0.00	0.00
1963	1970	8.64	7.18	0.07	1.39	0.00	8.57	0.07	0.00	0.00
1971		8.62	7.16	0.07	1.39	0.00	8.55	0.07	0.00	0.00

REMARKS: Layout is to scale as of 1933.

(1) This work not done under these project numbers but lies within the limits of these projects.

R.L.-7 REV. 2-40

PREPARED BY
HIGHWAY PLANNING SURVEY
IN COOPERATION WITH
U. S. PUBLIC ROADS ADMINISTRATION

STATE OF MINNESOTA
DEPARTMENT OF HIGHWAYS
ROAD LIFE STUDIES
CONSTRUCTION PROJECT LOG RECORD

CONTROL SECTION 3413
TRUNK HIGHWAY 23
COUNTY Kandiyohi
DISTRICT 8A

LIMITS: N.Jct.TH 71 - Jct T.H.9

Ref. Pt. 152+00.420 - 160+00.927

YEAR BUILT	PROJECT Nº	DESCRIPTION: TYPE	WIDTH	THICKNESS	REMARKS	CODE Nº
C		Grading	40'44'			
1955	3413-02	Bit. Stab. Base	40'44'	6"	On 12" Sand-Gr. & Salv.	
	3413-03	Plant Mix. Bit.	24'44'	3"	Mat'l Sub-base	
M					RC-5, 32527 Gal.	
1956	A.F.E.605	Bit. Seal Coat	24'44'		Agg. 1155 C.Y.	
C		Grading Bases *		*19"	Divided Highway	
1963	3412-05	Plant Mix Bit.	24'	3½"		
	3412-34002	Br 34002 WB.Rdwy	20'		14.7' B.S. -O.H.	
C		Grading Bases*		*16"	Divided 0.19 mi.	
1971	3413-09	Plant Mix Bit.	24'	3"		
		Plant Mix Bit. Shoulders				
M						
1977	SF	Bit. Shoulders	10'	3"	AC-1 15279.3 Ton	
C						
1986	4207	Bit. Overlay	24'	1"	Spec. 2331	
C						
1988	3414-11	Bit. Overlay	24'	1½"	Spec. 2341	
C		Grading		10"	Spec. 2331	
1988	3413-18	Bit. Surfacing	24'	1"	Spec. 2361	
C		Grading		6"	Spec. 2331	
1988	3413-19	Bit. Surfacing	24'	1"	Spec. 2341	
M						
1989	4349	Spot Overlay		1½"	Spec. 2341	
C						
1992	3413-23	Mill & Bit. Overlay	24'	1"	Spec. 2361	
C						
1994	M94148	Bit. Overlay	24'	1½"	Spec. 2341	
		Bit. Shoulder	9'	1½"	Spec. 2341	
C		Grading	44'			
2004	S02257	Aggregate	44'	2'	Class 3 Class 6	EBL
		Bit. Surfacing	24'	½'	Spec 2360	WBL
M						
2011	8828-113	Agg Seal &			FA-2	
		Fog Seal				

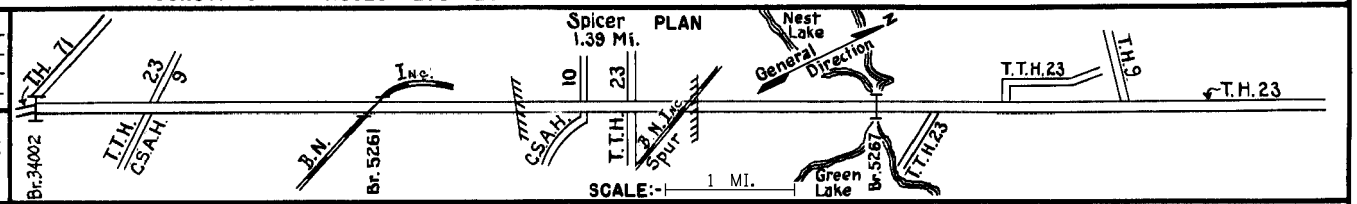

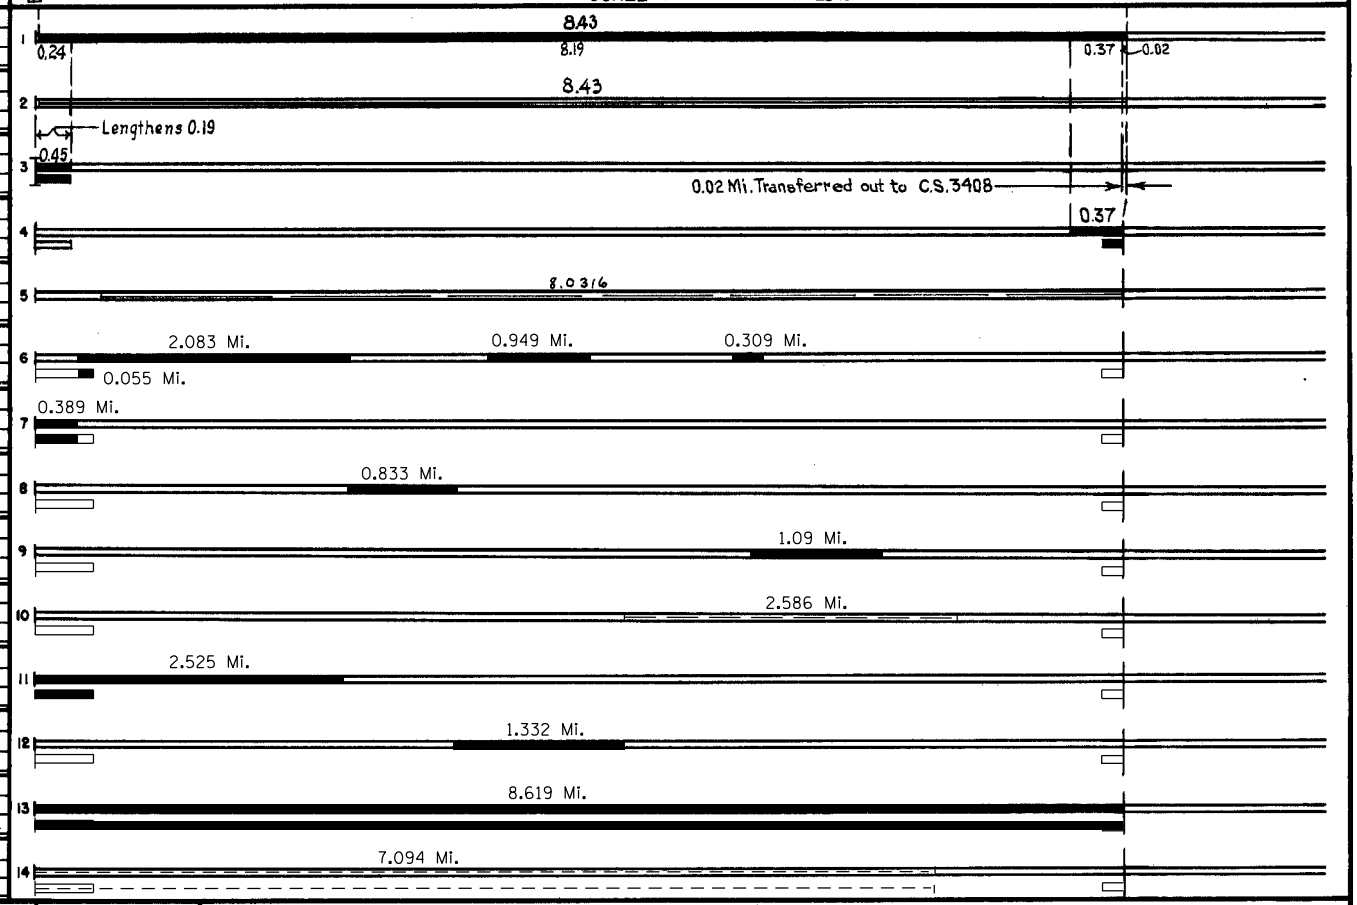

YEARS FROM	YEARS TO	TOTAL MILES	UNINCORPORATED RDWY. MI.	UNINCORPORATED BR. MI.	INCORPORATED RDWY. MI.	INCORPORATED BR. MI.	RURAL RDWY. MI.	RURAL BR. MI.	URBAN RDWY. MI.	URBAN BR. MI.

REMARKS: See Sheet No. 1

FORM RL-7

PREPARED BY
BUREAU OF POLICY & PLANNING
IN COOPERATION WITH
U. S. DEPARTMENT OF TRANSPORTATION - FEDERAL HIGHWAY ADMINISTRATION

STATE OF MINNESOTA
DEPARTMENT OF TRANSPORTATION
CONSTRUCTION PROJECT LOG RECORD

CONTROL SECTION 3413
TRUNK HIGHWAY 23
COUNTY Kandiyohi
DISTRICT 8A

LIMITS: N. Jct USTH-71 - Jct. MNTH-9

Ref. Pt. 152+00.420 - 160+00.927

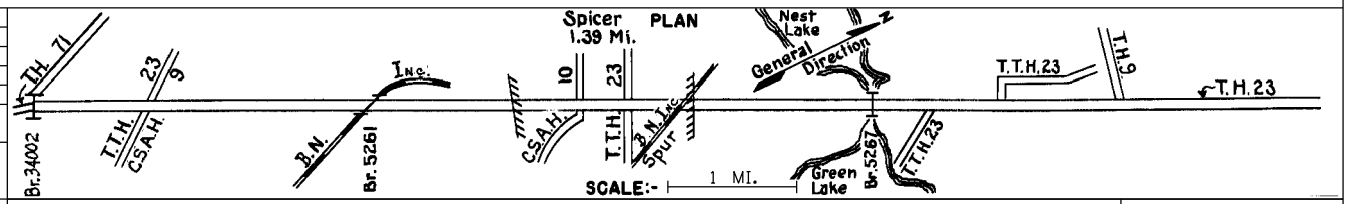

YEAR BUILT	PROJECT No	DESCRIPTION: TYPE	WIDTH	THICKNESS	REMARKS	
M		As Built				
2018	3413-90	Mill Bit. Pavemt	var.	.625"	special	WB
		Ultra Thin Bonded WC	var.	.625"	w/shldrs & TL's	EB

8.797 Mi. net

1
2
3
4
5
6
7
8
9
10
11
12
13
14

YEARS FROM	YEARS TO	TOTAL MILES	UNINCORPORATED RDWY. MI.	UNINCORPORATED BR. MI.	INCORPORATED RDWY. MI.	INCORPORATED BR. MI.	RURAL RDWY. MI.	RURAL BR. MI.	URBAN RDWY. MI.	URBAN BR. MI.

REMARKS: